

A BLOCK

Architectural floor plan of Block A, a four-unit residential building. The plan shows a symmetrical layout with two units on each side of a central corridor. Each unit includes a bedroom, living room, kitchen, bathroom, and balcony. The central corridor provides access to an open terrace for each unit. The plan is labeled with dimensions, room names, and furniture symbols.

Room Details and Dimensions:

- Unit 1 (Top Left):**
 - Bedroom: 3.50x4.10
 - Bathroom: 1.50x2.50
 - Kitchen: 2.95x3.00
 - Living Room + Dining: 3.30x4.10
 - Bedroom: 3.50x3.80
 - Bathroom: 1.50x2.50
 - Kitchen: 2.95x3.00
 - Living Room + Dining: 3.30x4.10
- Unit 2 (Top Right):**
 - Bedroom: 3.50x4.10
 - Bathroom: 1.50x2.50
 - Kitchen: 2.95x3.00
 - Living Room + Dining: 3.30x4.10
 - Bedroom: 3.50x3.80
 - Bathroom: 1.50x2.50
 - Kitchen: 2.95x3.00
 - Living Room + Dining: 3.30x4.10
- Unit 3 (Bottom Left):**
 - Bedroom: 3.50x4.10
 - Bathroom: 1.50x2.50
 - Kitchen: 2.95x3.00
 - Living Room + Dining: 3.30x4.10
 - Bedroom: 3.50x3.80
 - Bathroom: 1.50x2.50
 - Kitchen: 2.95x3.00
 - Living Room + Dining: 3.30x4.10
- Unit 4 (Bottom Right):**
 - Bedroom: 3.50x4.10
 - Bathroom: 1.50x2.50
 - Kitchen: 2.95x3.00
 - Living Room + Dining: 3.30x4.10
 - Bedroom: 3.50x3.80
 - Bathroom: 1.50x2.50
 - Kitchen: 2.95x3.00
 - Living Room + Dining: 3.30x4.10

Other Features:

- Central Corridor:** Access to an open terrace for each unit.
- Open Terrace:** Located at the bottom of the plan, accessible from all units.
- Dimensions:** Overall dimensions are 3.90m, 3.00m, 3.35m, 4.50m, 3.35m, 3.00m, 3.90m, 3.00m.
- Room Labels:** BEDROOM, TOILET, KITCHEN, LIVING ROOM + DINING, BALCONY, OPEN TERRACE.
- Furniture Symbols:** Bed, toilet, sink, stove, refrigerator, dining table, and kitchen fixtures.

The floor plan illustrates a symmetrical four-unit residential building. The central core features a staircase and common hallways (D1, D2, D3, D4). Each of the four units is equipped with a bedroom, a living room with dining area, a kitchen, a toilet, and a balcony. The plan includes detailed dimensions for individual rooms and overall building measurements.

Room Dimensions:

- Bedrooms:** 3.50x4.10, 3.20x4.00, 3.50x3.90, 3.20x4.00, 3.50x3.80, 3.50x4.10
- Living Rooms + Dining:** 5.30x5.00, 5.30x5.00
- Kitchens:** 2.95x3.90, 2.95x3.00
- Toilets:** 1.60x2.40, 1.50x2.50, 2.50x1.60
- Balconies:** 1.00m wide, 1.00m wide, 1.00m wide, 1.00m wide

Overall Dimensions:

- Width:** 9.92, 3.92, 3.00, 3.35, 4.50, 3.35, 3.00, 3.90
- Depth:** 10.80, 11.90, 9.90, 10.00

REVISED TYPICAL SECOND & THIRD FLOOR PLAN

SCHEDULE OF OPENINGS		SCHEDULE OF OPENINGS	
TYPE	SIZE	TYPE	SIZE
D1	1.00 X 2.50	W3	1.08 X 1.30
D2	0.90 X 2.50	W4	1.30 X 1.30
D3	0.90 X 2.20	V1	0.60 X 1.00
D4	0.75 X 2.20	V2	1.50X0.60
FD1	2.20 X 2.50	RS1	3.00X4.50
W1	2.00 X 1.30	RS2	2.50X4.50
W2	2.15 X 1.30	RS3	2.25X4.50

CHIEF OFFICER,
MARGAO MUNICIPAL COUNCIL

Municipal Engineer

Development Permission Granted
Subject To Conditions Vide Order
No. SGPD/P/15928/1478/2024
Dated 16.03.2024...

Member Secretary

OWNER : MR. ANAND BHAURAO DALAL

 **SAWANT & ASSOCIATES**
ARCHITECTS, ENGINEERS
INTERIOR DESIGNERS
SAPANA ARCADE, 1ST FLOOR
MALBHAT, GDA.
PHONE NO.(0): 2736693

Atkhang
HEALTH OFFICER
URBAN HEALTH CENT
MARGAO

UDAY SAWANT
B.E.(CIVIL)
Reg. No. ER/0022/2010

30.56
28.80

6.00

BASEMENT PARKING
28,400 S.F.

TOTAL NOS. OF PARKING = 14 NOS.

ELECTRICAL ROOM
3,000 S.F.

10' 1300 (14)

1.68 1.30 10' 1

2.91 1.51 8.71

4.50 4.90

14.58

Architectural floor plan of the first floor of a building. The plan shows eight shops (SHOP 1 to SHOP 8) and a central staircase. Shop 1 is 3.50x8.50, Shop 2 is 3.00x8.50, Shop 3 is 2.95x9.45, Shop 4 is 4.50x6.35, Shop 5 is 2.95x9.45, Shop 6 is 3.00x8.85, Shop 7 is 3.50x11.30, and Shop 8 is 2.80x11.30. The plan includes dimensions for the building footprint (11.70m by 6.90m) and various structural elements like walls, doors, and stairs. A note indicates "VENTILATION AT REZANNE LEVEL".

[illegible]

Section view of the building showing the ramp level, actual ground level, and basement parking area. The diagram includes a car in the basement parking area and a note about light and ventilation through mechanical means.

[illegible]

BASEMENT FLOOR	S5			BASEMENT FLOOR AREA -N PARKING(S)= 2554.55 (STAIRCASE) + X (LIFT) +445.37 (PARKING)= 8.33x 202.40= 6.37 (STAIRCASE)+ +445.37 (PARKING)=19.50 (STAIRCASE)+3.04 (LIFT)
	S4	X	S4	
	S3			


The diagram shows a 2D grid layout. At the top, a horizontal bar is labeled 'S3'. Below it, a row contains 'S2', 'X', and 'S2'. Below that, a row contains 'S1'. The main body of the grid is divided into five large rectangular areas labeled A, B, C, D, and E. Area A is on the left, B is in the middle, C is below B, D is to the right of C, and E is to the right of D. A vertical bar labeled 'Q' is on the far left, and a horizontal bar labeled 'M' is at the bottom left.

B1		B3	S1	B3		B1
H			S2	X	S2	H
G		K	S1	K		G
F						
L		B2		B2		L
B1		OT1	OT2	OT3	OT4	B1
						OT5

Figure 1: Typical Group 1 and 2 Floor Plan. The diagram shows a symmetrical floor plan. At the top, there are two small rooms labeled 'B1' and 'H'. Below these are two larger rooms labeled 'G' and 'K'. The central corridor is labeled 'F'. At the bottom, there are two small rooms labeled 'L' and 'B1'. The plan is symmetrical about a vertical axis.

B3		B3			B1
					H
K		K			G
F					
B2		B2			L
					B1

RD FLOOR

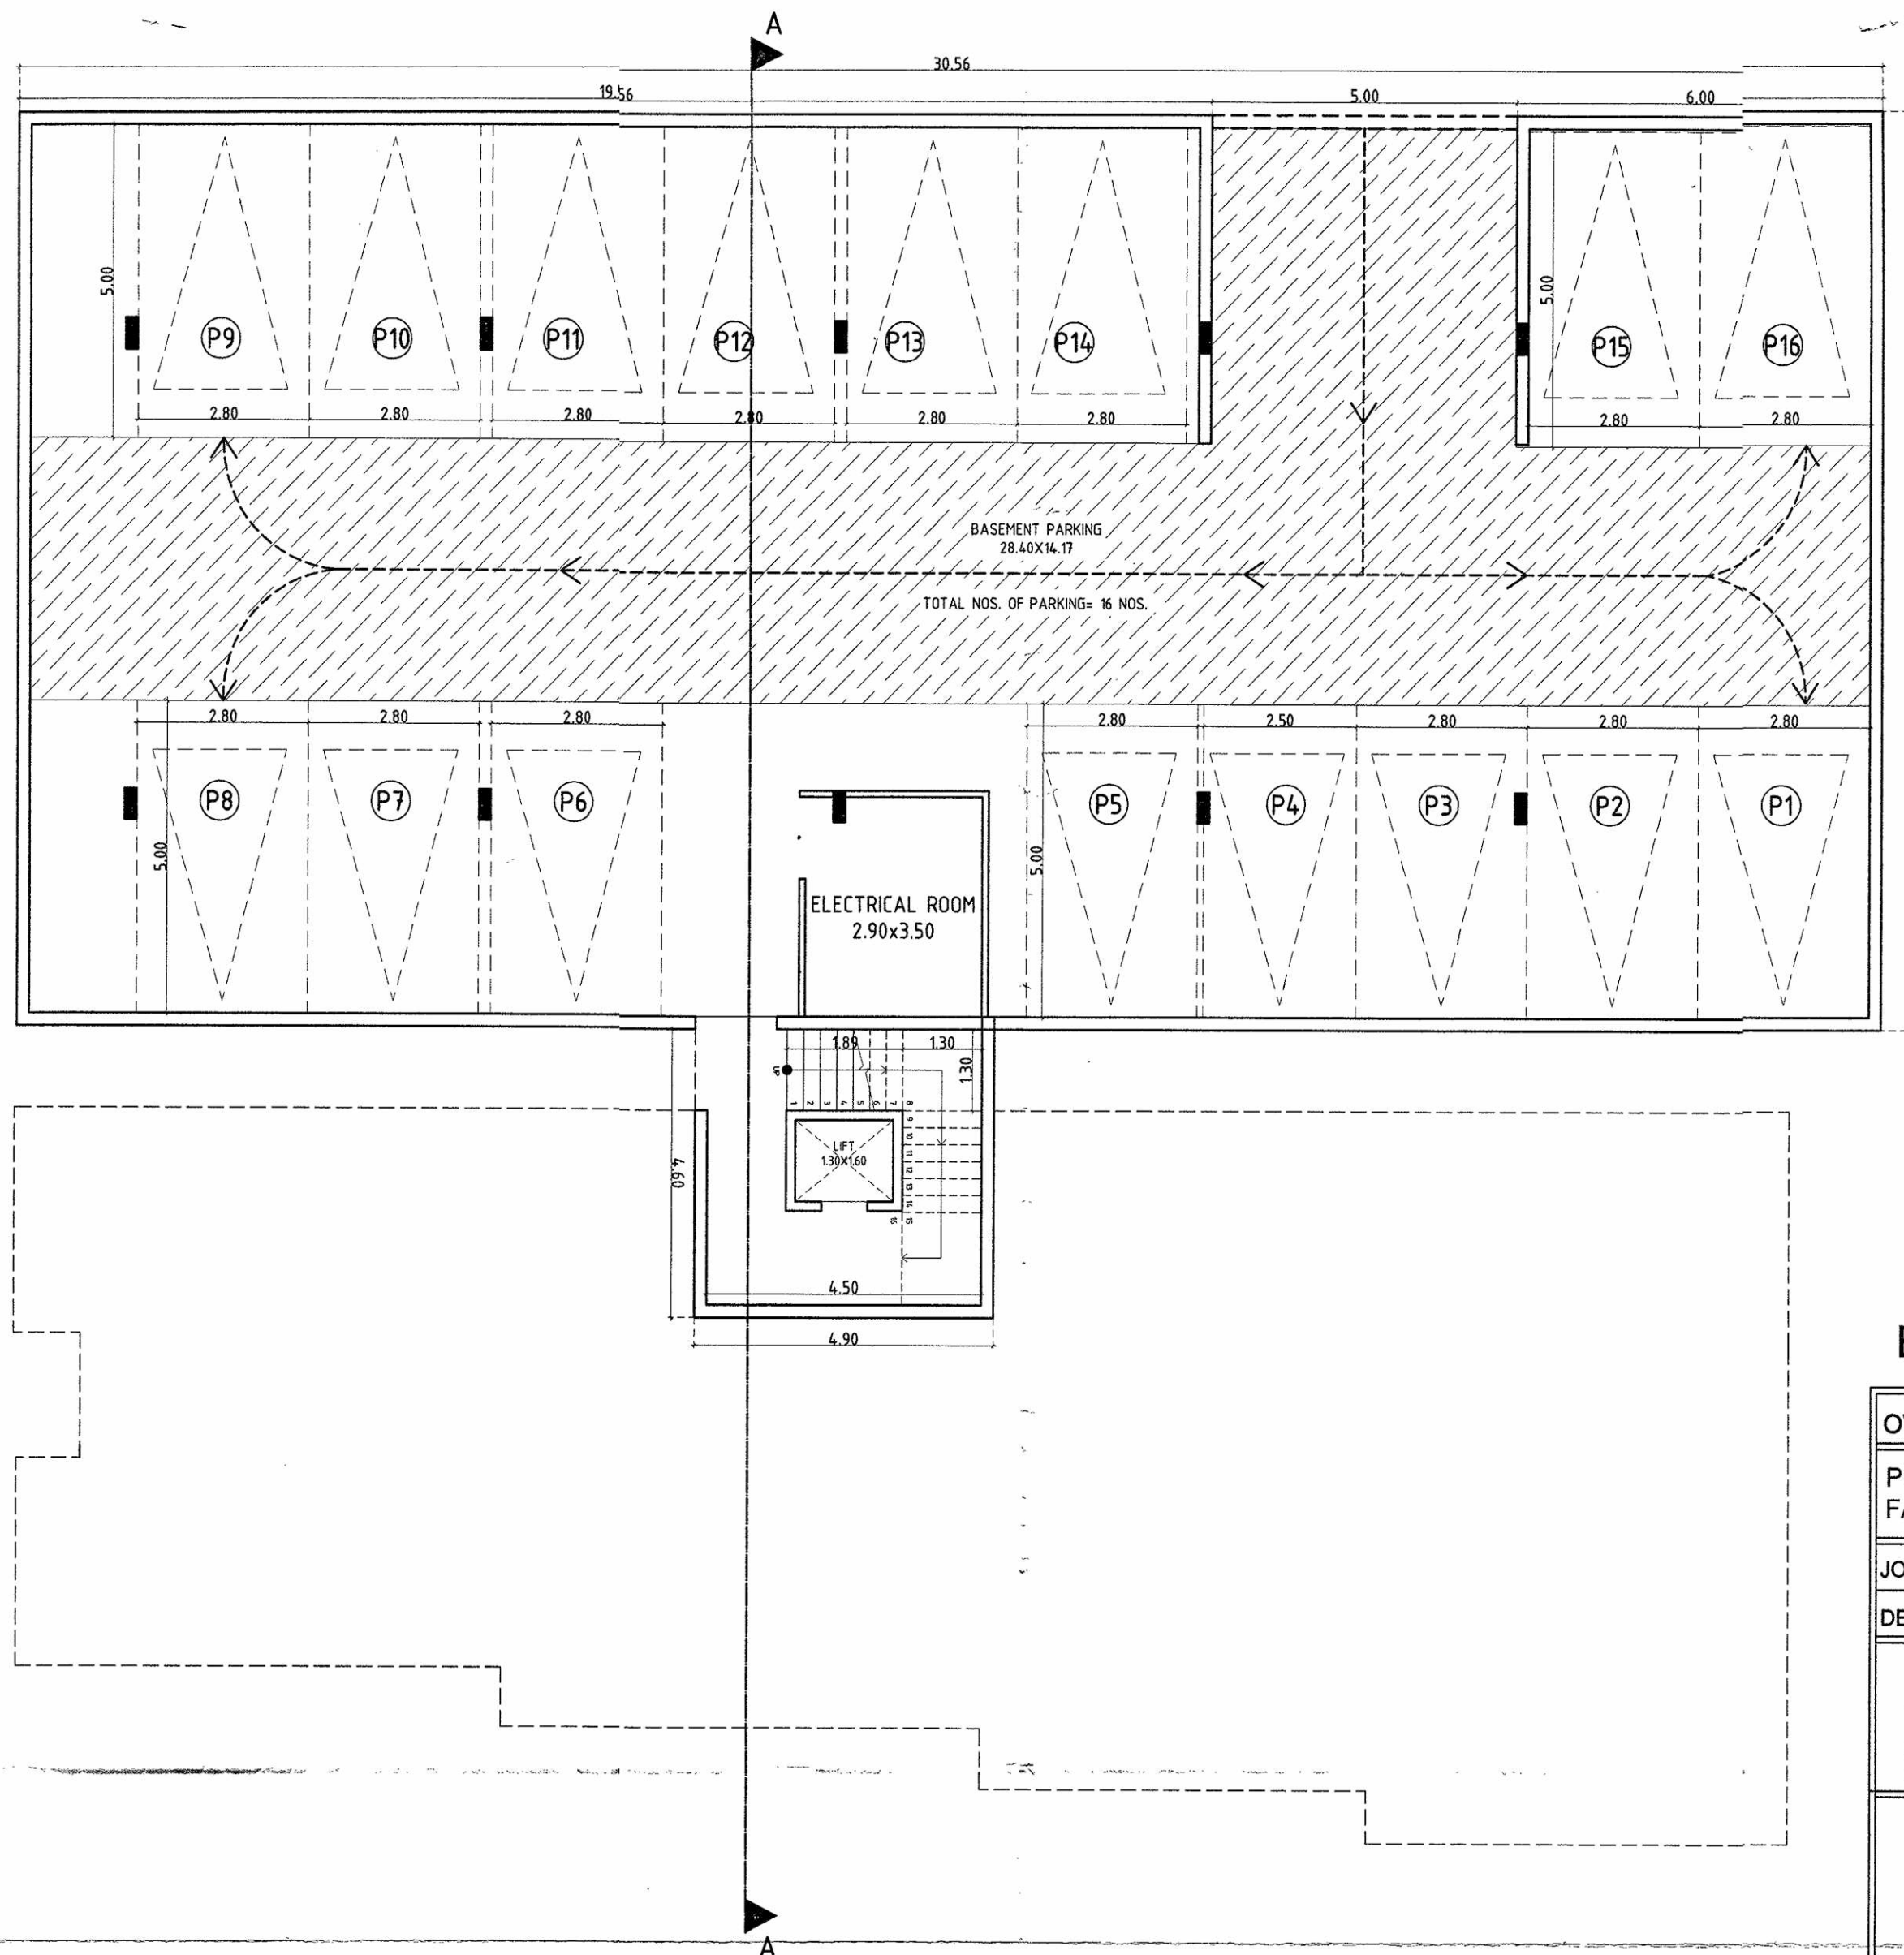

REVISED BASEMENT FLOOR PLAN SHOWING INTERNAL CHANGES

(Revised Plan) Dated 08/07/2021
 License issued under No. 184/17-18 Dated 27/02/2018
 Subject to the conditions stipulated therein

[Signature]
 CHIEF OFFICER,
 MARGAO MUNICIPAL COUNCIL

[Signature]
 Municipal Engineer
 Margao Municipal Council

Development Permission Granted
 Subject To Conditions Vide Order
 No. SGPDA/P/5938/176/21-22
 Dated 10/05/2021

[Signature]
 Member Secretary

BLDG A- BASEMENT FLOOR- AS BUILT PLANS

OWNER : MR. ANAND BHAURAO DALAL		
PROJECT : COMMERCIAL/ RESIDENTIAL BUILDINGS AND CLUBHOUSE AT AMBAJI, FATORDA SALCETE GOA		
JOB NO-2278	CHALTA NO.8 / P.T.SHEET No.35	DATE-20-04-2021
DEALT-LEEANN	SCALE- 1:100	DRG. NO-664
 SAWANT & ASSOCIATES ARCHITECTS, ENGINEERS INTERIOR DESIGNERS SAPANA ARCADE, 1ST FLOOR MALBHAT, GOA. PHONE NO.(0): 2736693		
OWNER'S SIGNATURE: <i>[Signature]</i>		ARCHITECT'S SIGNATURE : UDAY SAWANT B.E.(CIVIL) Reg. No. ER/0022/2010